



**MATERIAL  
INSPECTION  
REQUEST**

**OMNIYAT**

**BSBG**

**CONTRACT :** Plot 18 by Dorchester Collection

**CONTRACT No:** 201A22002

**Requested By :** ELENCO

**MIR Ref. No.:**

**ELE-AX-MR-PW-00004**

**Signature :** *[Signature]*

**Revision No:**

**00**

**Subcontractors No.**

**ELE-AX-MR-PW-00003**

**Date :**

**1-Feb-23**

**Discipline :**

STRU

MEP

OTHERS

The following items are ready to inspect on **03-Feb-2023** by **10:00 am.**

**Subcon No.** **ELE-AX-MR-PW-00004**

**Material Description:** Material Delivery Inspection Request for Custom Fabricated Kitchen Equipment as per the attached DO No. ELE-DC-010223 and approved custom fabrication drawing.

**Material Submittal Ref:**...

**Specification No :**...

**Quantity :** ...as per the attached DO

**Attached :**  Checklist  Sketches  Others  Delivery Note

**Manufacturer's Details : as per the attached**

**Manufacturer :**...as per the attached

**Batch No. :**

**Date of Manufacture :**

**Delivery Note No :** ELE-DC-010223

**Invoice No :**

**Country of Origin :** LOCAL

**Date of arrival on site :**

**Storage Location :**

**Compliance Statement:** The contractor hereby confirms that the Material offered for inspections are ready and compliance with the Contract Documents.

Adequate HSE measures are in place for storage.

**Inspection Report :**

**Physical Damage ?**

YES

NO

**Details Given Above Correct ?**

YES

NO

**Conform with Approved submission ?**

YES

NO

**Details :**.....

**Remarks :**.....

**Engineer's Comments :**

The above material has been inspected on site and found at time of inspection to be :

**Satisfactory**

**Unsatisfactory**

**Inspected by :** .....

**Date :** .....

Approved

Approved with Comments

Revise & Resubmit

Rejected

Fondue will inspect all equipment once installation is complete

GD

07.02.2023

**Name:** George K

**Signature :**

**Date :** 06-02-2023

**Project Manager's Approval**

**Name:** .....

**Signature :** .....

**Date :** .....

ص.ب : ١٠٣ - أبوظبي - الامارات العربية المتحدة - تلفون : ٦٧٧٨٨٨٠ - ٠٢ - فاكس : ٦٧٧١٣٩١

P.O. Box : 103 - Abu Dhabi - United Arab Emirates, Tel. : 02 - 6778880, Fax : 02 - 6771391

Branch: Al Ain: P.O. Box: 17442, Tel: 03-7644478, Fax: 03-7644479 - www.elencogroup.com - Email: info@elencogroup.com / sales@elencogroup.com  
An Elenco Emirates Group Company إحدى شركات مجموعة الينكو الإمارات

### DELIVERY NOTE

PROJECT: DORCHESTER COLLECTION (PLOT 18) @ BUSINESS BAY

DO NO. : ELE-DC-010223

MAIN CONTRACTOR: M/S KHANSAHEB

DATE : 01.02.2023

Item No.	Make	Model	Description	Qty
<b>FOOD SERVICE EQUIPMENT</b>				
BASEMENT 1 LEVEL				
<b>FL.00 FLOWER ROOM AND STORE</b>				
FL.04	Custom	Custom	U' Shaped Support Bench with Double Sink Bowl	1
FL.05	Custom	Custom	Wall Cupboards	2
FL.06	Custom	Custom	Wall Cupboards	2
<b>RD.00 RECEIVING and DECANT</b>				
RD.02	Custom	Custom	Support Bench with Sink Bowl	1
RD.03	Custom	Custom	Runs of 2 Tier Wall Shelvings	2
<b>RW.00 RAW WASH</b>				
RW.02	Custom	Custom	Support Bench with Double Sink Bowls	1
RW.07	Custom	Custom	Support Bench with Sink Bowl	1
RW.11	Custom	Custom	Runs of 2 Tier Wall Mounted Storage Shelvings	2
<b>SDP.00 STAFF DINING SUPPORT PANTRY</b>				
SDP.01	Custom	Custom	Preparation Table with Sink Bowl	1
SDP.04	Custom	Custom	Wall Shelf	1
<b>GROUND FLOOR LEVEL</b>				
<b>BQ.00 BANQUET KITCHEN AND SUPPORT</b>				
BQ.01	Custom	Custom	Worktop c/w Lowered Handwash Station	1

<b>Item No.</b>	<b>Make</b>	<b>Model</b>	<b>Description</b>	<b>Qty</b>
BQ.04	Custom	Custom	Mobile Set-up Tables (Cold)	4
a	Custom	Custom	Island Gantry c/w Task Light	4
BQ.05	Custom	Custom	Mobile Set-up Tables (Hot)	5
a	Custom	Custom	Hot Cupboards with Sliding Door	5
c	Custom	Custom	Island Gantry c/w Heat Lamps	5
BQ.11	Custom	Custom	Ambient Base Unit c/w Tray Runners	1
BQ.20	Custom	Custom	Outlet Table	1
BQ.21	Custom	Custom	Dishwash Deposit / Inlet Table c/w Pre- rinse Spray	1
a	Custom	Custom	Roll-over Rack Shelf	1
BQ.29	Custom	Custom	Cleaner's Sink	1
BQ.32	Custom	Custom	Rack Shelf	1
BQ.33	Custom	Custom	Wall Cupboards	3
BQ.34	Custom	Custom	Beverage Dispense Counter	1
a	Custom	Custom	Lowered Handwash Station	1
b	Custom	Custom	Lowered Blender Stations	2
c	Custom	Custom	Insulated Ice Well	1
d	Custom	Custom	Speedrail	1
e	Custom	Custom	Underslung Sink Unit	1
f	Custom	Custom	Stainless Steel Understructure and Storage/Drawers	1
g	Custom	Custom	Storage Overshelf	1
BQ.36	Custom	Custom	Rear Beverage Counter	1
BQ.38	Custom	Custom	Wine Racks	3
BQ.42	Custom	Custom	Worktop c/w Sink Unit	1
BQ.47	Custom	Custom	Movable Table - Dishwash Deposit	1

35

For ELENCO :



RECEIVED BY: \_\_\_\_\_








The Novacef® Solution  
for LASER Fiber & LASER CO<sub>2</sub>

The Novacef® Solution  
for LASER Fiber & LASER CO<sub>2</sub>  
for LASER  
CO<sub>2</sub>-Fiber  
CO<sub>2</sub>-Cluster

for LA

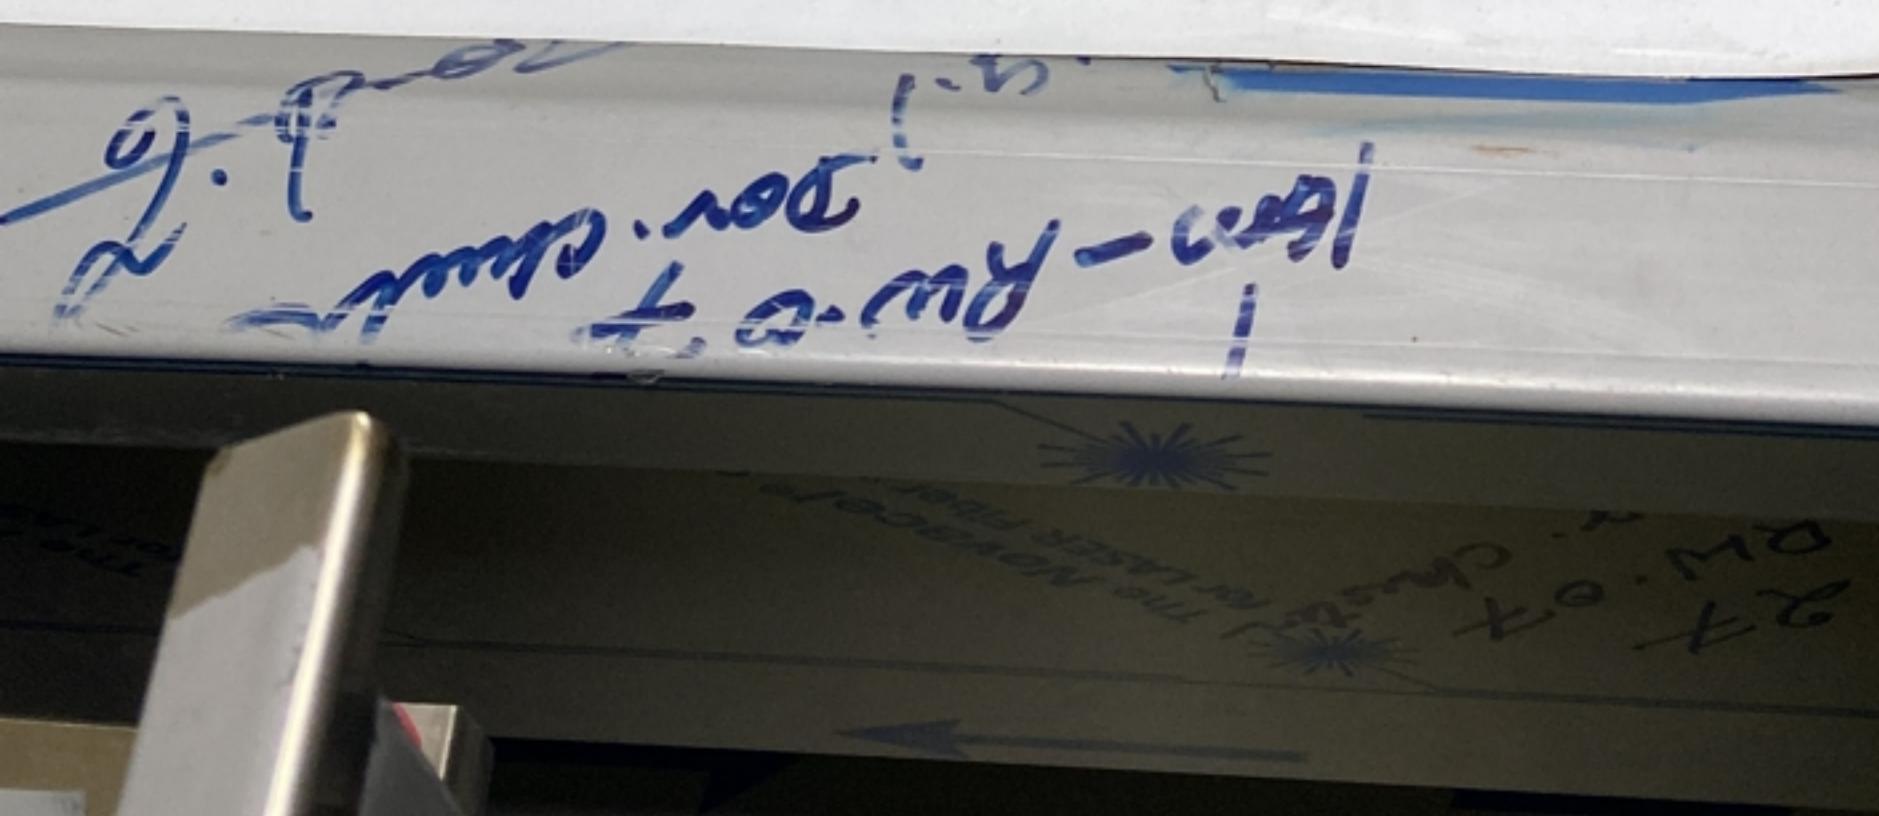



















## SHOP DRAWING

Project:	Contractor / Package	Document No.	Revision
Plot 18 by Dorchester Collection	Khansaheb Civil Engineering LLC	ELE-AX-SD-B1-01005	01
To: Khansaheb Civil Engineering	Omniyat Middle East Real Estate Development LLC	Submittal Issue Date:	29.08.2022

**Discipline:**  Architectural  Structural  Structural Steel  Electrical  Plumbing  Interior Design  
 Infrastructure  Landscape  Mechanical  Survey  Waterproofing  Ceiling  Others (.....)



Submission Type	
<input type="checkbox"/> Material Submission <input type="checkbox"/> Calculation <input type="checkbox"/> Pre-Qualification	<input type="checkbox"/> Manual <b>xx Shop Drawing</b> <input type="checkbox"/> Method Statement
<b>Location of Use:</b> Basement 1	
<b>Contract Specification Clause Ref:</b>	
<b>PROPOSED</b> [NB: For alternative materials a Compliance Report must be provided]	
MFR AGENT	MFR AGENT
MAKE/ MODEL	MAKE/ MODEL

<b>Contractor Review Comments:</b>	<b>Digital Stamping</b>
Name.....  Signature.....  Date.....	

<b>Consultant Review Comments:</b>	<b>Digital Stamping</b>
Fondue:- Refer Fondue comments on attached dwg	
	
Name.....  Signature.....  Date.....	

<b>Lead Consultant Review Comments:</b>	<b>Digital Stamping</b>
<div style="border: 1px solid green; padding: 5px;">         BSBG:          -Refer to FND comments.       </div>	
KRIS  Name.....  Signature.....  Date.....	

<b>Employer's Representative (Omniyat) Review Comments:</b>	<b>Digital Stamping</b>
<div style="border: 1px solid purple; padding: 5px;">         Refer the consultant comment       </div>	
SM-OME-07/09/2022  Name.....  Signature.....  Date.....	Status-B

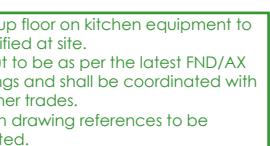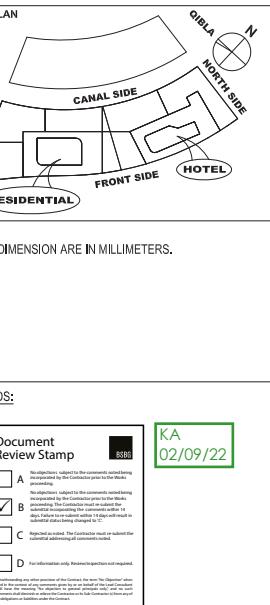

FND:1614.61.101.00	00	LOADING DOCK, RECEIVING, RAW MATERIALS
DRAWING NO. REV.		DRAWING TITLE
REFERENCES		
ISSUED FOR APPROVAL		22-08-2022
ISSUED FOR APPROVAL		29-06-2022
<b>Description</b>		<b>Date</b>
Certified for Coordination and Compliance with the Contract documents		
	Subcontractor	Sig.
	MEP - ELECTRICAL	
	MEP - PLUMBING	
	MEP - HVAC	
	ALUMINUM	

## KHANSAHEB REVIEW

The image shows the Omniyat logo at the top right, which consists of the word "OMNIYAT" in a bold, black, sans-serif font with a red horizontal bar through the letter "I". Below the logo is a horizontal line of text: "ONE BUSINESS BAY TOWER", "DUBAI, U.A.E.", "115000 F +971 4 5115005", "CONSULTANT", "SMITH BREWER GULF", and "0667". To the right of "SMITH BREWER GULF" is a small black square.

DUSSELDORF BUSINESS POINT,  
AL BARSHA 1, DUBAI UAE  
47524  
FO@BGEENG.COM  
FENG.COM

**WME** T +971 4 388 1616  
E info@wmeglobal.com  
W www.wmeglobal.com

**CONSISTENT**  
CONSISTENT CONSULTANTS  
CONSISTENT CONSULTANTS

RACTOR:  


el: 04 605 7200, Fax: 04 285 7539, www. khansaheb.ae  
TRACTOR:

Branch : Al Ain - P.O.Box 17442 - Tel: 7644478 - Fax: 7644479  
[www.alencogroup.com](http://www.alencogroup.com)

**3130 (VERIFY AS PER SITE DIMENSION)**

**FL.08**

**SITE WELDING**

**PLAN**  
Scale: 1:25

**FLOWER ROOM**

Dimensions: 750, 1630, 750, 2800, 2200, 700, 700, 700, 700, 700, 700, 700.

Key features include:

- Two rectangular columns at the top corners with dimensions 400 x 500 mm.
- Two rectangular columns at the bottom corners with dimensions 400 x 500 mm.
- Two vertical columns on the left side with dimensions 400 x 500 mm.
- Two vertical columns on the right side with dimensions 400 x 500 mm.
- Welding points labeled R.L.04, R.L.05, R.L.06, R.L.07, R.L.08, and R.L.09.
- Flower pots labeled FL.07 and FL.08.
- Callouts A, B, and C indicating specific areas of interest.

**RAW WASH**

**PLAN**  
Scale: 1:20

**PLAN**  
Scale: 1:25

Dimensions: 1670, 2480, 1520, 750, 500 x 500 mm, 500 x 600 mm, 800.

Fixtures: RW.11, RW.09, RW.08, RW.12, RW.07, RW.10, RW.06.

Symbols: D, E, F.

**RECEIVING & DECANt**

Scale: 1:25

G

**ON DUE COMMENTS ON CONSTRUCTION DETAIL ON THIS DRAWING WILL BE TYPICAL FOR ALL FABRICATION ITEMS ON HIS PROJECT UNLESS COMMENTED OTHERWISE.**

The diagram illustrates the front elevation of a shelving system labeled 'THRILL-A'. The system consists of two main vertical columns of shelves. The left column has a height of 1400 mm, with a 700 mm section at the top and a 700 mm section below. The right column also has a height of 1400 mm, with a 700 mm section at the top and a 700 mm section below. Between the columns is a central section with a height of 750 mm. The top section of each column contains a 'Removable mid Shelf' (FL.06) located 350 mm from the top. The middle section of each column contains 'Two removable mid Shelves' (FL.06). The bottom section of each column contains a 'S/S SINK FRONT PANEL' and a 'S/S BASE SHELF' (FL.04). The distance between the centers of the two central sections is 3130 mm. The distance between the centers of the two bottom sections is 1530 mm. The distance between the centers of the two top sections is 780 mm.

**FRONT ELEVATION THRU - B**

1380      1380

FL.06      FL.06

700

2800

150

1400

900

650

550

300

660

S/S BASE SHELF

S/S BASE SHELF

FL.04

FL.07

S/S LOCKABLE DRAWER

S/S LOCKABLE DRAWER

S/S INT SHELF

S/S INT SHELF

Comply with Fondue comments on sample inspection report

Each cupboard section to be lockable

**FRONT ELEVATION THRU - C**

2200

FL.05      FL.05

700

2200

150

1400

900

650

730

S/S BASE SHELF

S/S BASE SHELF

S/S INT SHELF

S/S INT SHELF

S/S LOCKABLE DRAWER

S/S LOCKABLE DRAWER

Two removable mid Shelves

Comply with Fondue comments on sample inspection report

FL.04

FL.05

3

200.06

FRONT

Each cupboard section to be lockable

**ELEVATION THRU - D**

Provide additional vertical support brackets

1530

RW.11

1830

RW.07

S/S D/WK FRONT PANEL

S/S BASE SHELF

Fixed base Shelf

150

150

1400

900

150

150

**FRONT ELEVATION THRU - E**

Provide additional vertical support brackets

1620

RW.11

1670

RW.07

S/S INT. SHELF

S/S BASE SHELF

1400

900

150

150

150

**FRONT ELEVATION THRU-FLOOR PLAN**

Scale: 1:25

Refer and comply with Fondue comments on sample inspection report

Refer and comply with Fondue comments on sample inspection report

RW.08

RW.01

RD.01

2500

180

900

150

S/S SINK FRONT PANE

S/S BASE SHELF

1270

410

620

Detailed description: This technical drawing shows a front elevation through a floor plan. A central horizontal line represents the floor level. On the left, there is a cabinet unit with a height of 180 and a base shelf height of 900. To the right of this unit is a stainless steel sink area with a height of 150. The sink front pane has a height of 1270. Above the sink is a stainless steel base shelf with a height of 410. A red arrow points from the text 'S/S BASE SHELF' to this shelf. To the right of the sink area is a vertical cabinet labeled 'RW.10'. Further to the right, another vertical cabinet is labeled 'RW.01'. At the far right, a vertical cabinet is labeled 'RD.01'. A red box at the top right contains the text 'Refer and comply with Fondue comments on sample inspection report'. Two identical red boxes are located at the top left.

**SECTION 4-4**

Scale: 1:25

Fondue comments on sample inspection report

**DETAILS - C**  
Scale: NTS

**DETAILS - D**  
Scale: NTS

<b>ITEM No.</b>	<b>DESCRIPTION</b>
FL_04	U-SHAPED SUPPORT BENCH WITH DOUBLE SINK BOWL
FL_05	WALL CUPBOARDS
FL_06	WALL CUPBOARDS
RW_02	SUPPORT BENCH WITH DOUBLE SINK BOWL
RW_07	SUPPORT BENCH WITH SINK BOWL
RW_11	RUNS OF 2 TIER WALL MOUNTED STORAGE SHELVINGS
RW_11	RUNS OF 2 TIER WALL MOUNTED STORAGE SHELVINGS
RW_08	MOBILE VERTICALE SINK BOWLS
RD_02	SUPPORT BENCH WITH SINK BOWL
RD_03	RUNS OF 2 TIER WALL SHELVINGS



**Fondue:-**

- All fabrication items shall be accordance with Fondue General specification standards, section 8 and Fondue Elevation drawings.
- Comply with all comments on fabrication sample inspection report.
- Caulk and seal all gaps within bench work.
- Caulk and seal all gaps between bench work and architectural finishes. Caulking thickness shall not exceed a maximum of 5mm. Obtain proper site dimension/prepare templates prior to fabrication.
- Ensure sound deadening material is fully clad in stainless steel and not exposed to moisture/water at any penetration points on bench/counter tops
- Provide earth bonding lugs and coordinate with related contractor to provide earth bonding as maybe required on this project.
- All electrical cabling where required shall be run through proper insulated conduit within

## SHOP DRAWING

Project:	Contractor / Package	Document No.	Revision
Plot 18 by Dorchester Collection	Khansaheb Civil Engineering LLC	ELE-AX-SD-B1-04005	00
To: Khansaheb Civil Engineering	Omniyat Middle East Real Estate Development LLC	Submittal Issue Date:	29.08.2022

**Discipline:**  Architectural  Structural  Structural Steel  Electrical  Plumbing  Interior Design  
 Infrastructure  Landscape  Mechanical  Survey  Waterproofing  Ceiling  Others (.....)


<b>Staff Dining Support Pantry Area Custom Fabrication</b> <b>Drawing @ Basement 1</b>	<b>Submission Type</b>	
	<input type="checkbox"/> Material Submission <input type="checkbox"/> Calculation <input type="checkbox"/> Pre-Qualification	<input type="checkbox"/> Manual <b>xx Shop Drawing</b> <input type="checkbox"/> Method Statement
<b>Location of Use:</b> Basement 1	<b>Contract Specification Clause Ref:</b>	
<b>PROPOSED</b> <small>[NB: For alternative materials a Compliance Report must be provided]</small>		
MFR AGENT  MAKE/ MODEL	MFR AGENT  MAKE/ MODEL	

<b>Contractor Review Comments:</b>	<i>General arrangement drawings are captured</i>		<b>Digital Stamping</b>
Name.....	Signature.....	Date.....	

<b>Consultant Review Comments:</b>	<b>Digital Stamping</b>
Fondu:- Refer Fondu comments on attached dwg	
Name.....	George K
Signature.....	
Date.....	01-09-2022

<b>Lead Consultant Review Comments:</b>	<b>Digital Stamping</b>
<span style="border: 1px solid green; padding: 2px;">BSBG: -Refer to FND comments.</span>	
	
KRIS	02/09/22
Name.....	Signature.....
Date.....	

<b>Employer's Representative (Omniyat) Review Comments:</b>	<b>Digital Stamping</b>
<span style="background-color: #e0e0ff; border: 1px solid black; padding: 2px;">Refer the consultant comment</span>	
	
Name.....	SM-OME-07/09/2022
Signature.....	
Date.....	

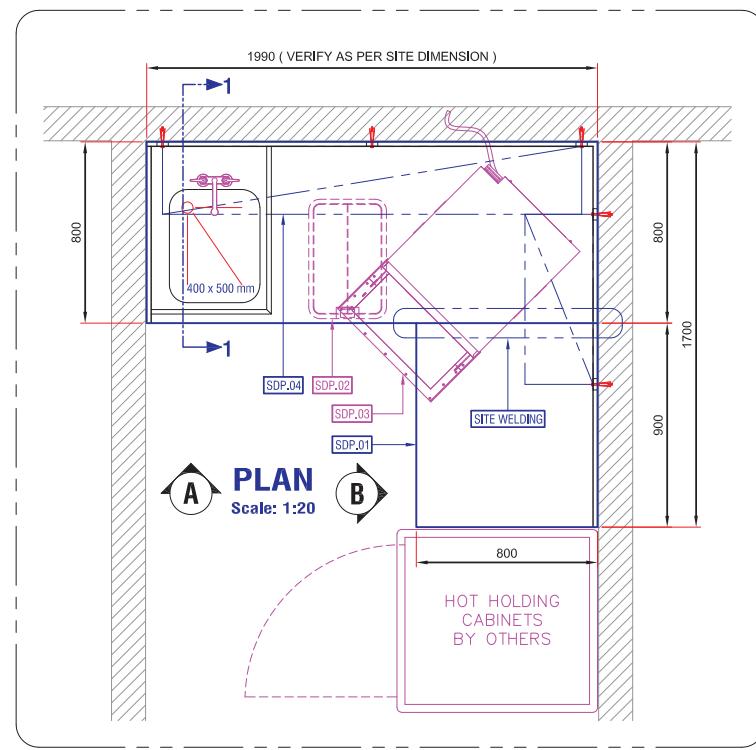


**Fondue:**

- All fabrication items shall be accordance with Fondue General specification standards, section 8 and Fondue Elevation drawings.
- Comply with all comments on fabrication sample inspection report.
- Caulk and seal all gaps within bench work.
- Caulk and seal all gaps between bench work and architectural finishes. Caulking thickness shall not exceed a maximum of 5mm. Obtain proper site dimension/prepare templates prior to fabrication.
- Ensure sound deadening material is fully clad in stainless steel and not exposed to moisture/water at any penetration points on bench/counter tops
- Provide earth bonding lugs and coordinate with related contractor to provide earth bonding as maybe required on this project.
- All electrical cabling where required shall be run through proper insulated conduit within the bench/counter frame work.

DORCHESTER HOTEL DUBAI	
01-09-2022	
<b>STATUS</b>	<b>DESCRIPTION</b>
A	APPROVED TO PROCEED WITH NO COMMENT
B	APPROVED SUBJECT TO ALL COMMENTS BEING INCORPORATED
C	REJECTED. RESUBMIT INCORPORATING ALL COMMENTS
D	NO COMMENT REQUIRED FROM FONDUE TEAM

Refer Fondue Comments on construction details on dwg ELE-AX-SD-B1-01005-01

BASEMENT LEVEL 1		
AREA: STAFF DINING SUPPORT PANTRY		
ITEM No.	DESCRIPTION	QTY.
SDP.01	PREPARATION TABLE WITH SINK BOWL	1
SDP.04	WALL SHELF	1

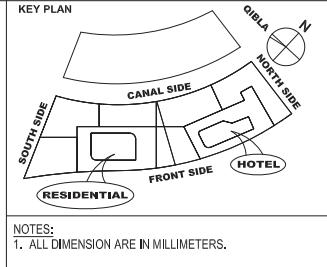

LEGENDS:








KA  
02/09/22

Document Review Stamp

<input type="checkbox"/> A	No objections subject to the comments noted being incorporated by the Contractor prior to the Works.
<input checked="" type="checkbox"/> B	Approved Subject to all comments being incorporated.
<input type="checkbox"/> C	Rejected. Resubmit incorporating all comments.
<input type="checkbox"/> D	No comment required from Fondue Team.


Instructions: Please check the boxes for the comments subject to which you have no objection. If any comments are rejected, please incorporate them before proceeding with the works. If any comments are accepted, please resubmit the revised drawing.

- Build-up floor on kitchen equipment to be verified at site.
- Layout to be as per the latest FND/AX drawings and shall be coordinated with the other trades.
- Design drawing references to be indicated.

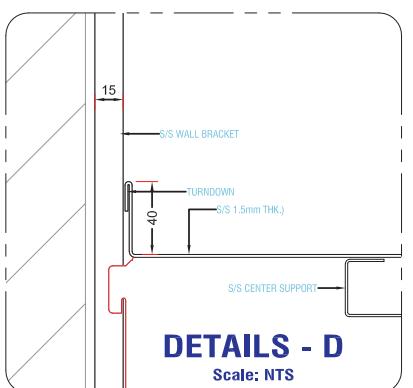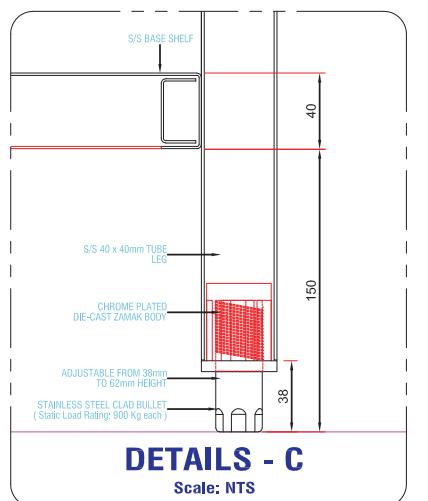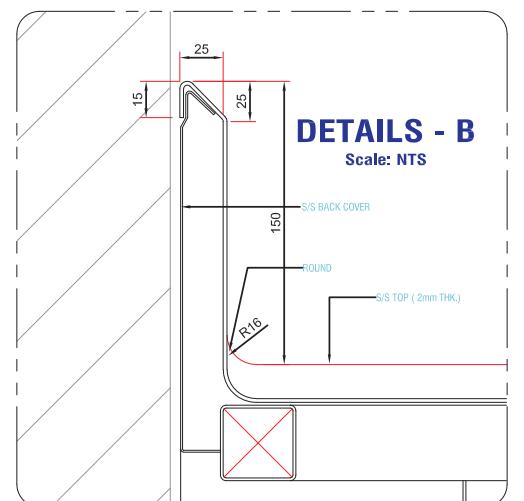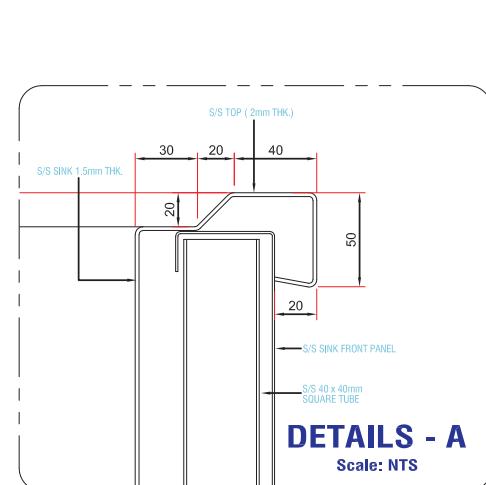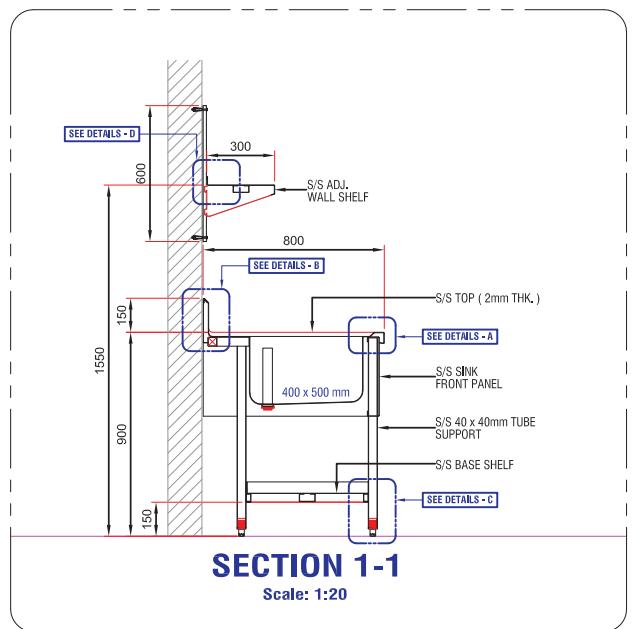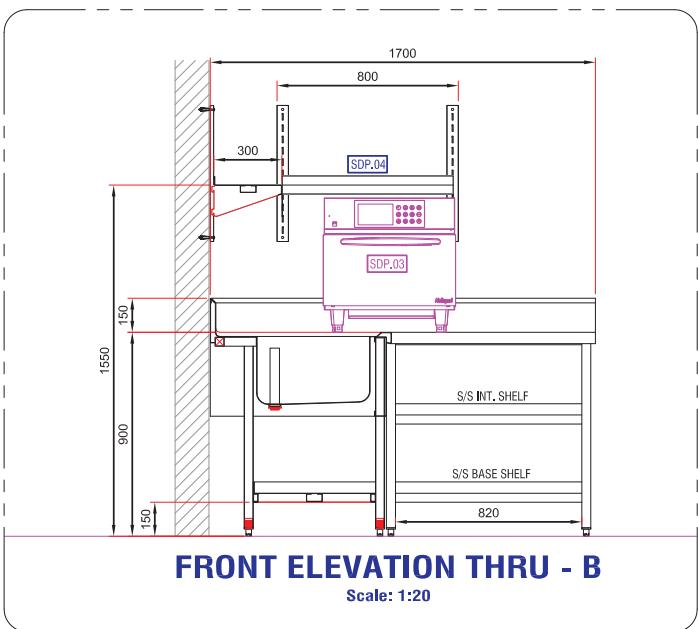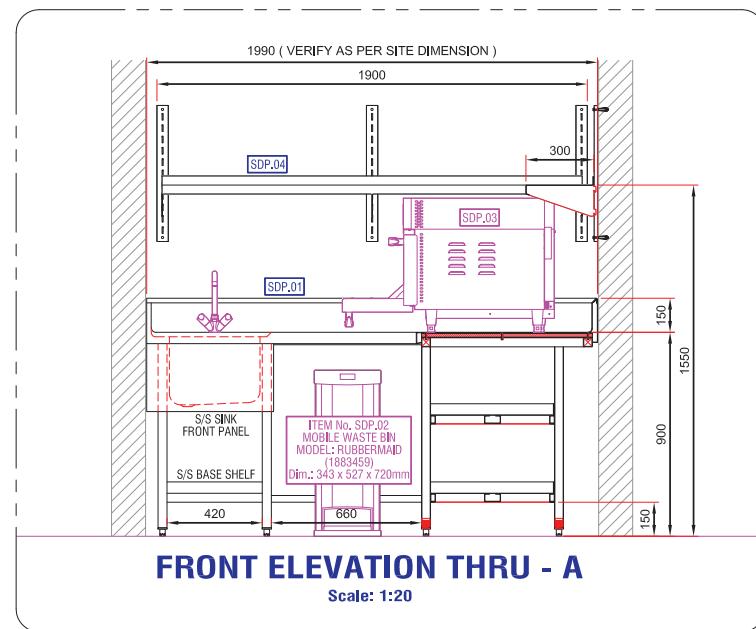

**REFERENCE**

X	FND.1614.B1.104.00	00	STAFF DINING ROOM AND SUPPORT
S.NO.	DRAWING NO.	REV.	DRAWING TITLE
REFERENCES			
00 ISSUED FOR APPROVAL 22-09-2022 TAJ			
Rev	Description	Date	BY
Certified for Coordination and Compliance with the Contract documents			
Date,	Subcontractor	Sig.	
MEP - ELECTRICAL			
MEP - PLUMBING			
MEP - HVAC			
ALUMINUM			
OTHERS			
<b>KHANSAHEB REVIEW</b>			
Date	Signature		
CLIENT: OMNIYAT PROPERTIES FIFTEEN LTD LEVEL 1 ONE BUSINESS BAY TOWER BUSINESS BAY, DUBAI U.A.E. T: +971 4 515000 F: +971 4 515005			
DESIGN CONSULTANT: BREWER SMITH BREWER GULF P.O.BOX 30097 T: +971 4 4472042 F: +971 4 2942101 EMAIL: INFO@BSBGULF.COM			
STRUCTURE ENGINEER: BGAE 1007-1008 DUSSELDORF BUSINESS POINT, INTERCONTINENTAL & AL BARSHA 1, DUBAI UAE T: +971 4 4472024 E: info@bgae.com			
MEP ENGINEER: WME T: +971 4 388 1616 E: info@megtahal.com W: www.megtahal.com			
MEP CONSULTANTS: CONSISTENT ENGINEERING CONSULTANTS Post Box No: 125786, Bank Street, Bur Dubai, +1.U.A.E. T: +971 4 388 16001 F: +971 4 388 16002 Email: Info@consistentconsultants.com Website: consistentconsultants.com			
MAIN CONTRACTOR: KHANSAHEB CIVIL ENGINEERING L.L.C. Tel: 04 605 7200, Fax: 04 285 7539, www.khansaheb.ae			
SUB CONTRACTOR: elenco			
PROJECT: PROPOSED DEVELOPMENT ON PLOT 3466829 PLOT 18 DUBAI, UAE			
DRAWING TITLE: STAFF DINING SUPPORT PANTRY AREA CUSTOM FABRICATION DRAWING @ BASEMENT 1			
Drawn:	TAJ	Checked:	RA
SCALE:	AS SHOWN IN PLAN @ A1	DATE:	22-08-2022
DRAWING NO.	ELE-AX-SD-B1-04005	REV.	00

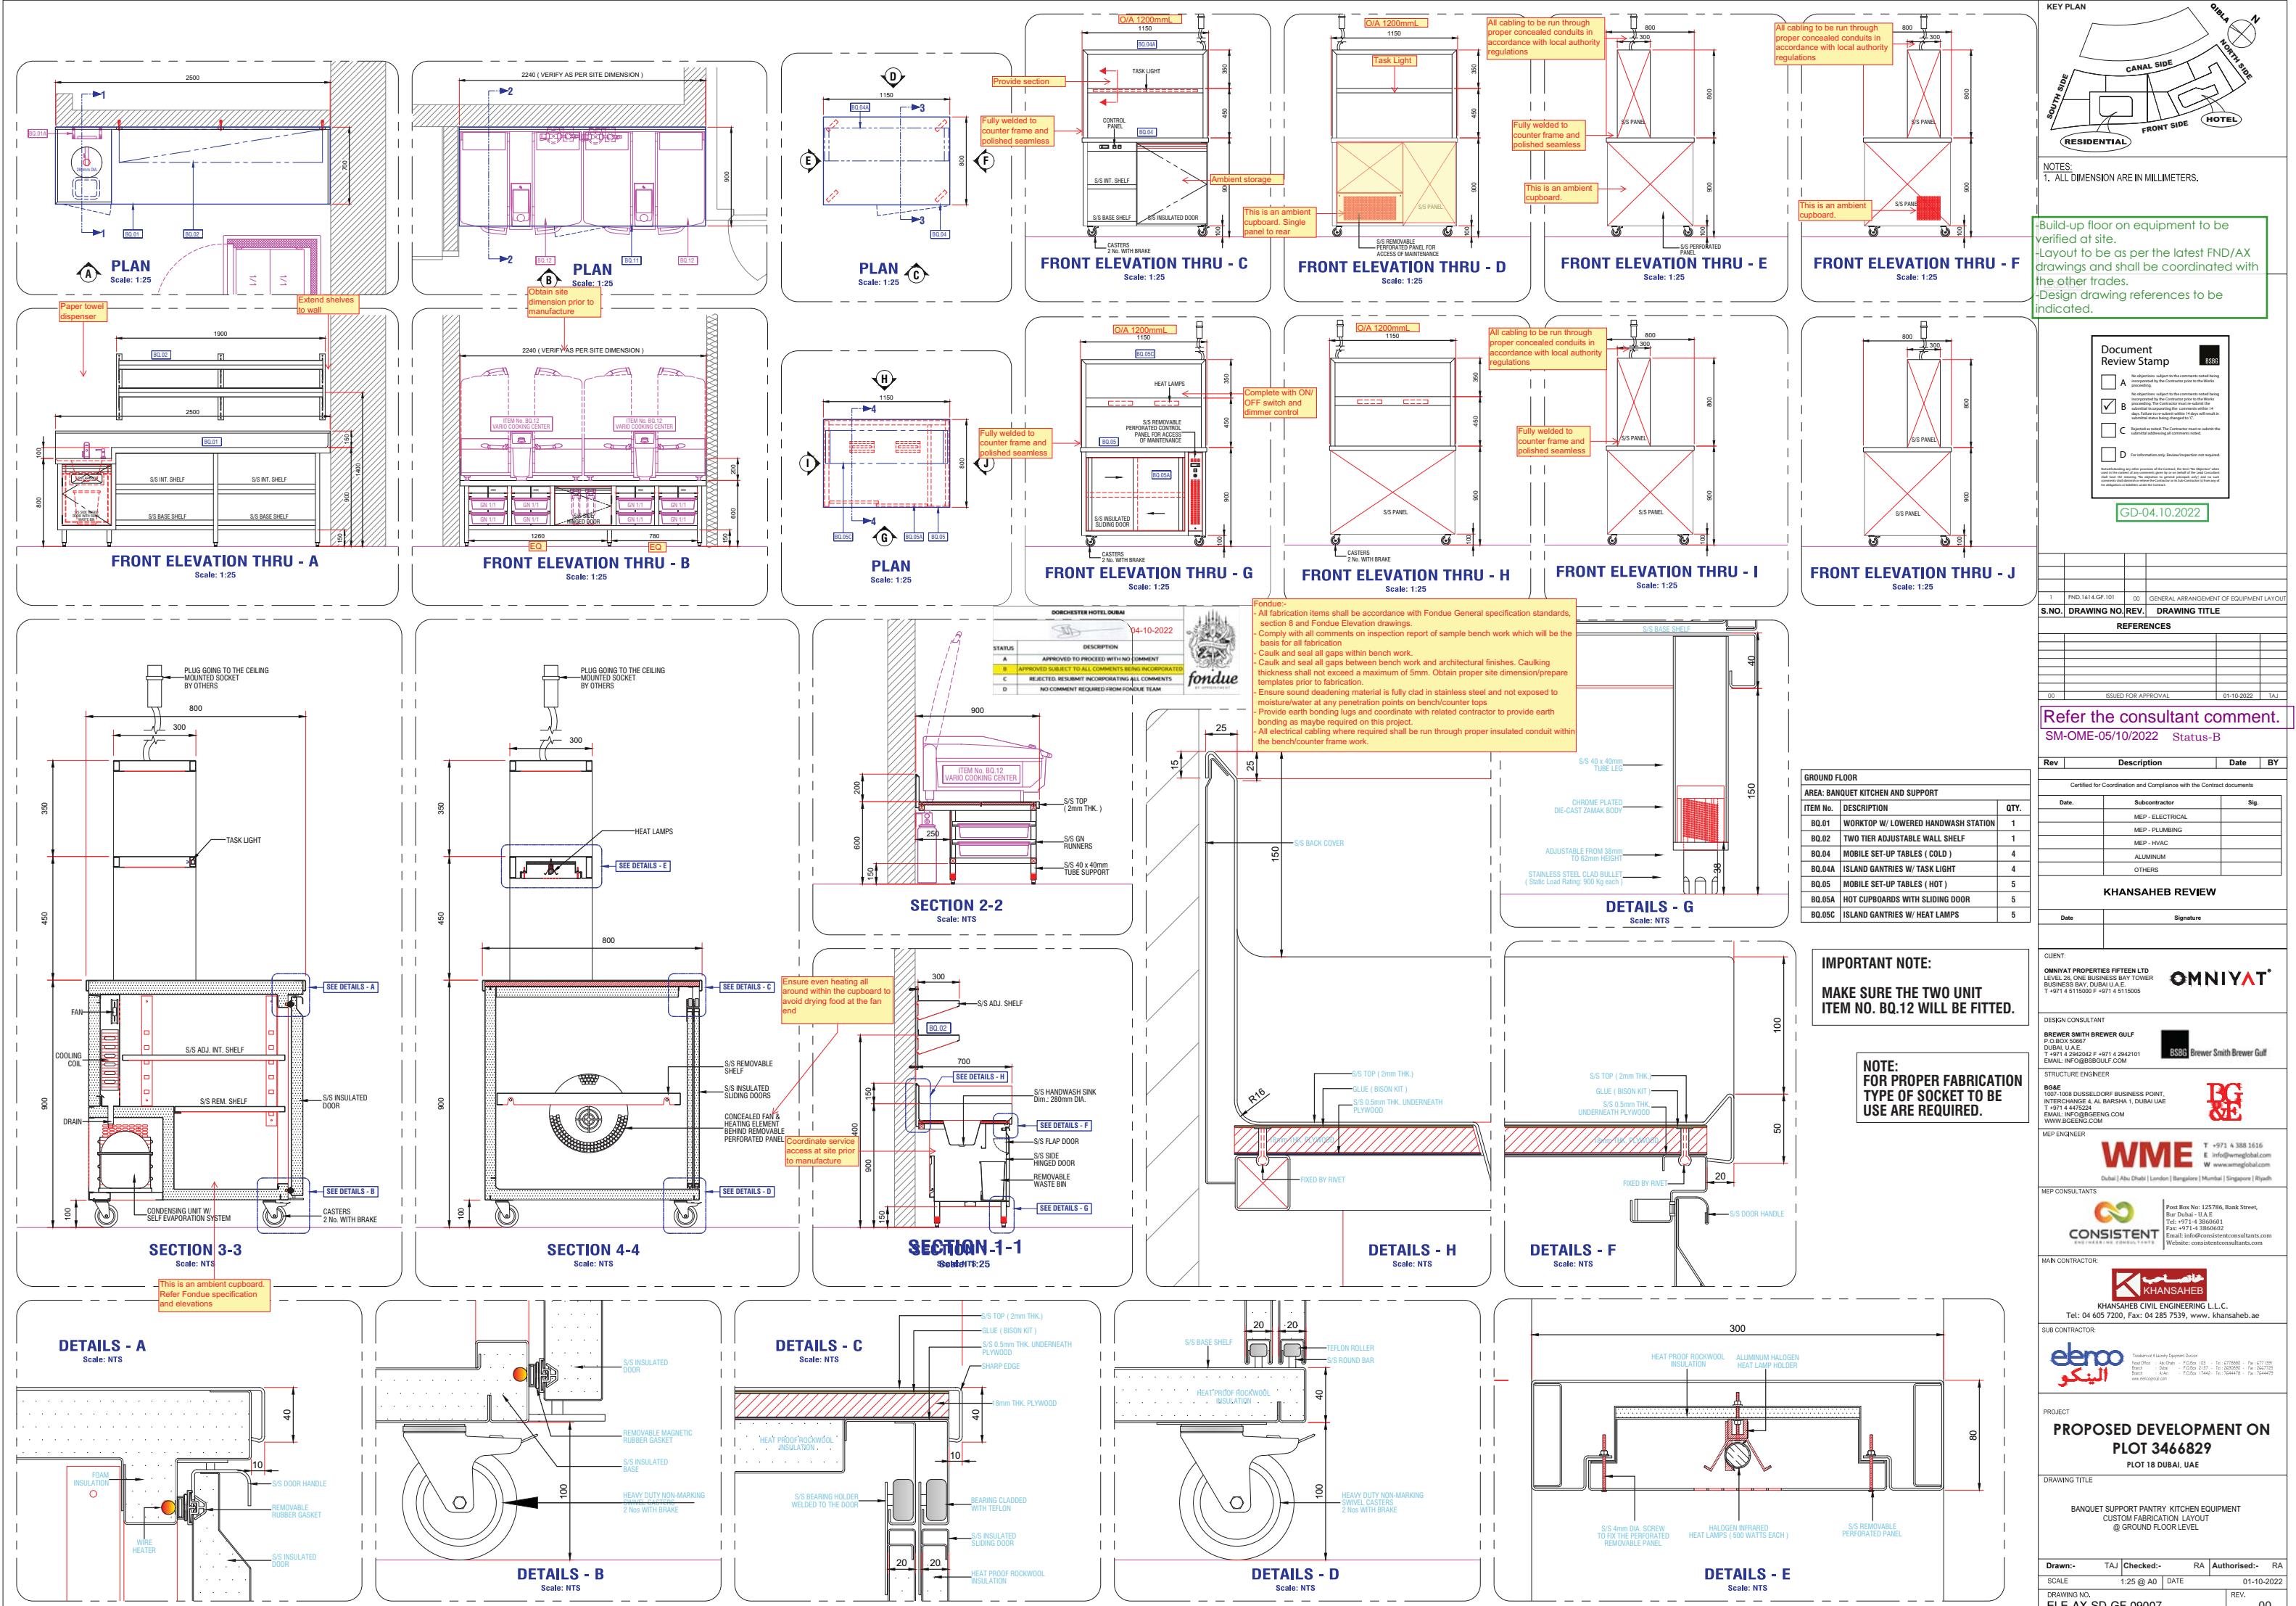

## SHOP DRAWING

Project:	Contractor / Package	Document No.	Revision
Plot 18 by Dorchester Collection	Khansaheb Civil Engineering LLC	ELE-AX-SD-GF-09008	00
To: Khansaheb Civil Engineering	Omniyat Middle East Real Estate Development LLC	Submittal Issue Date:	01.10.2022

**Discipline:**  Architectural  Structural  Structural Steel  Electrical  Plumbing  Interior Design  
 Infrastructure  Landscape  Mechanical  Survey  Waterproofing  Ceiling  Others (.....)

Submission Type	
<input type="checkbox"/> Material Submission	<input type="checkbox"/> Manual
<input type="checkbox"/> Calculation	<input checked="" type="checkbox"/> Shop Drawing
<input type="checkbox"/> Pre-Qualification	<input type="checkbox"/> Method Statement

Location of Use: Ground Floor Level	Contract Specification Clause Ref:
SPECIFIED	PROPOSED [NB: For alternative materials a Compliance Report must be provided]

MFR AGENT	MFR AGENT
MADE/ MODEL 	MADE/ MODEL

Contractor Review Comments:	Digital Stamping
Name..... Signature..... Date.....	

Consultant Review Comments:	Digital Stamping
Fondue: Refer Fondue comments on attached dwg	


DOORCHESTER HOTEL DUBAI	
STATUS	DESCRIPTION
<input type="checkbox"/> A	APPROVED TO PROCEED WITH NO COMMENT
<input checked="" type="checkbox"/> B	APPROVED SUBJECT TO ALL COMMENTS BEING INCORPORATED
<input type="checkbox"/> C	REJECTED. INSUBMIT INCORPORATING ALL COMMENTS
<input type="checkbox"/> D	NO COMMENT REQUIRED FROM FONDUE TEAM

Lead Consultant Review Comments:	Digital Stamping
Refer comments on the drawing	



Name.....	Signature.....	Date.....	Document Review Stamp								
George K		04-10-2022	<table border="1"> <tr> <td><input type="checkbox"/> A</td><td>No objection, subject to the comments noted being incorporated by the Contractor prior to the Works proceeding.</td></tr> <tr> <td><input checked="" type="checkbox"/> B</td><td>Approved subject to the comments noted being incorporated by the Contractor prior to the Works proceeding. The Contractor shall submit the revised submittal incorporating the comments within 14 days of the date of this stamp and make the submittal status being changed to C.</td></tr> <tr> <td><input type="checkbox"/> C</td><td>Rejected as noted. The Contractor must re-submit the revised submittal of comments noted.</td></tr> <tr> <td><input type="checkbox"/> D</td><td>For information only. Review/Inspection not required.</td></tr> </table> <p>Individuals may offer opinions of the comments. The Owner, when used in the context of an engineering project, is to be used to denote Consultant and/or Sub-Contractor. The term "Comments" refers to the written communication and demands on reference the Contractor or its Sub-Contractor to change its submittal.</p>	<input type="checkbox"/> A	No objection, subject to the comments noted being incorporated by the Contractor prior to the Works proceeding.	<input checked="" type="checkbox"/> B	Approved subject to the comments noted being incorporated by the Contractor prior to the Works proceeding. The Contractor shall submit the revised submittal incorporating the comments within 14 days of the date of this stamp and make the submittal status being changed to C.	<input type="checkbox"/> C	Rejected as noted. The Contractor must re-submit the revised submittal of comments noted.	<input type="checkbox"/> D	For information only. Review/Inspection not required.
<input type="checkbox"/> A	No objection, subject to the comments noted being incorporated by the Contractor prior to the Works proceeding.										
<input checked="" type="checkbox"/> B	Approved subject to the comments noted being incorporated by the Contractor prior to the Works proceeding. The Contractor shall submit the revised submittal incorporating the comments within 14 days of the date of this stamp and make the submittal status being changed to C.										
<input type="checkbox"/> C	Rejected as noted. The Contractor must re-submit the revised submittal of comments noted.										
<input type="checkbox"/> D	For information only. Review/Inspection not required.										

Employer's Representative (Omniyat) Review Comments:	Digital Stamping
Refer the consultant comment.	

Name.....	Signature.....	Date.....	Status-B
SM-OME-05/10/2022			

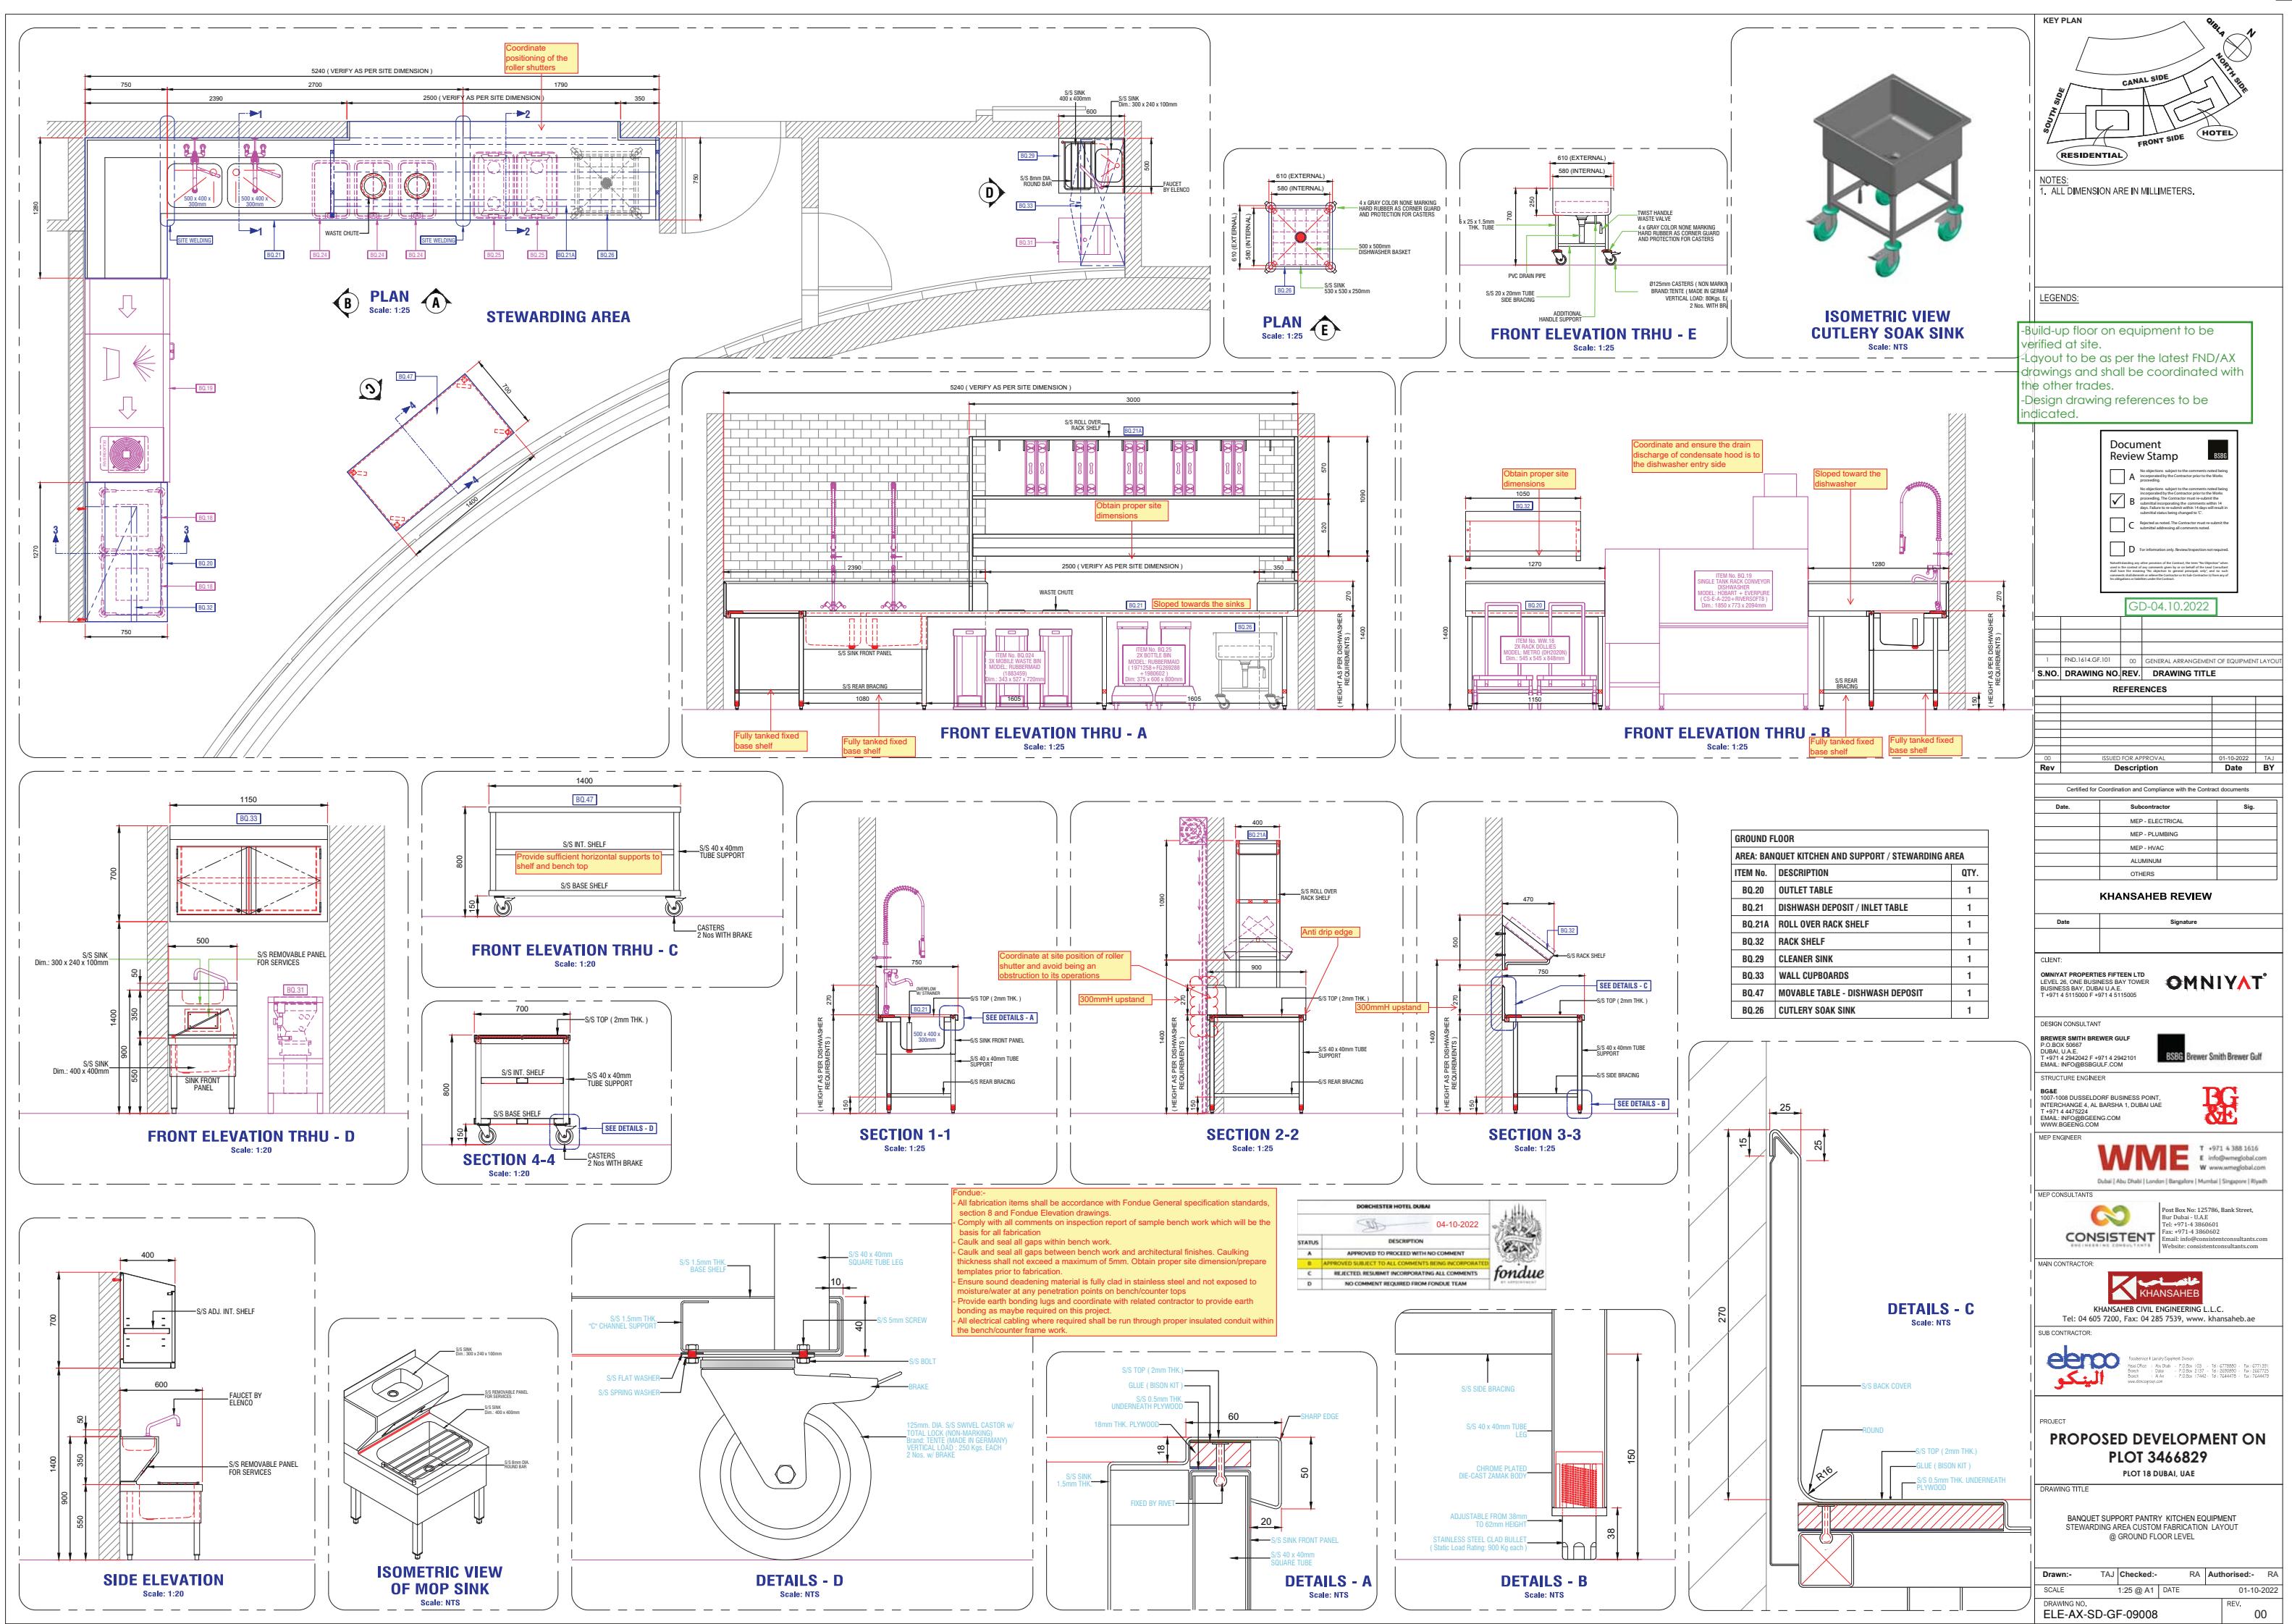

## SHOP DRAWING
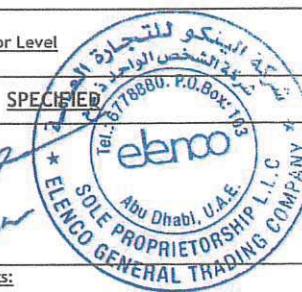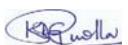
<b>Project:</b> Plot 18 by Dorchester Collection	<b>Contractor / Package</b> Khansaheb Civil Engineering LLC	<b>Document No.</b> ELE-AX-SD-GF-09009	<b>Revision</b> 00												
<b>To:</b> Khansaheb Civil Engineering	Omniyat Middle East Real Estate Development LLC	Submittal Issue Date:	01.10.2022												
<b>Discipline:</b> <input type="checkbox"/> Architectural <input type="checkbox"/> Structural <input type="checkbox"/> Structural Steel <input type="checkbox"/> Electrical <input type="checkbox"/> Plumbing <input type="checkbox"/> Interior Design <input type="checkbox"/> Infrastructure <input type="checkbox"/> Landscape <input type="checkbox"/> Mechanical <input type="checkbox"/> Survey <input type="checkbox"/> Waterproofing <input type="checkbox"/> Ceiling <input type="checkbox"/> Others (.....)															
<b>Banquet Support Pantry Kitchen Equipment Dispense Bar</b> <b>Area Custom Fabrication Layout @ Ground Floor Level</b>		<b>Submission Type</b> <input type="checkbox"/> Material Submission <input type="checkbox"/> Manual <input type="checkbox"/> Calculation <input checked="" type="checkbox"/> Shop Drawing <input type="checkbox"/> Pre-Qualification <input type="checkbox"/> Method Statement													
<b>Location of Use:</b> Ground Floor Level		<b>Contract Specification Clause Ref:</b>  <b>PROPOSED</b> <small>[NB: For alternative materials a Compliance Report must be provided]</small>													
MFR AGENT  MAKE/ MODEL  	 SPECIFIED Tel: 97188880, P.O.Box 103 Abu Dhabi, U.A.E. SOLE GENERAL TRADING COMPANY	MFR AGENT  MAKE/ MODEL													
<b>Contractor Review Comments:</b>  		<u>Digital Stamping</u>													
Name.....  George K	Signature.....  	Date.....  04-10-2022													
<b>Consultant Review Comments:</b> <b>Fondue:-</b> Refer Fondue comments on attached dwg		<u>Digital Stamping</u>													
Name.....  Lead Consultant Review Comments:  Refer comments on the drawing		<table border="1"> <tr> <td colspan="2">DORCHESTER HOTELS DUBAI</td> </tr> <tr> <td>STATUS</td> <td>DESCRIPTION</td> </tr> <tr> <td>A</td> <td>APPROVED TO PROCEED WITH NO COMMENT</td> </tr> <tr> <td>B</td> <td>APPROVED SUBJECT TO ALL COMMENTS BEING INCORPORATED</td> </tr> <tr> <td>C</td> <td>REJECTED. RE-SUBMIT INCORPORATING ALL COMMENTS</td> </tr> <tr> <td>D</td> <td>NO COMMENT REQUIRED FROM FONDUE TEAM</td> </tr> </table> 		DORCHESTER HOTELS DUBAI		STATUS	DESCRIPTION	A	APPROVED TO PROCEED WITH NO COMMENT	B	APPROVED SUBJECT TO ALL COMMENTS BEING INCORPORATED	C	REJECTED. RE-SUBMIT INCORPORATING ALL COMMENTS	D	NO COMMENT REQUIRED FROM FONDUE TEAM
DORCHESTER HOTELS DUBAI															
STATUS	DESCRIPTION														
A	APPROVED TO PROCEED WITH NO COMMENT														
B	APPROVED SUBJECT TO ALL COMMENTS BEING INCORPORATED														
C	REJECTED. RE-SUBMIT INCORPORATING ALL COMMENTS														
D	NO COMMENT REQUIRED FROM FONDUE TEAM														
Name.....  Signature.....  GD  Employer's Representative (Omniyat) Review Comments:  Refer the consultant comment.		<u>Digital Stamping</u> <table border="1"> <tr> <td colspan="2">Document Review Stamp</td> </tr> <tr> <td><input type="checkbox"/> A</td> <td>No objections subject to the comments something incorporated by the Contractor prior to the Works proceeding.</td> </tr> <tr> <td><input checked="" type="checkbox"/> B</td> <td>No objections subject to the comments being incorporated by the Contractor prior to the Works proceeding. The Contractor must re-submit the revised drawings within 14 days. Failure to re-submit within 14 days will result in a fine of 1000 AED per day.</td> </tr> <tr> <td><input type="checkbox"/> C</td> <td>Rejected as noted. The Contractor must re-submit the revised drawings addressing all comments noted.</td> </tr> <tr> <td><input type="checkbox"/> D</td> <td>For information only. Review/Inspection not required.</td> </tr> </table> <p><small>Nonwithstanding any other provision of the Contract, the term "No Objection" when used in relation to any matter or document or part thereof, shall mean that the Employer or his Agent has no objection to the matter or document or part thereof, and it shall not be construed as meaning that the Employer or his Agent has no objection to the obligations or liabilities under the Contract.</small></p>		Document Review Stamp		<input type="checkbox"/> A	No objections subject to the comments something incorporated by the Contractor prior to the Works proceeding.	<input checked="" type="checkbox"/> B	No objections subject to the comments being incorporated by the Contractor prior to the Works proceeding. The Contractor must re-submit the revised drawings within 14 days. Failure to re-submit within 14 days will result in a fine of 1000 AED per day.	<input type="checkbox"/> C	Rejected as noted. The Contractor must re-submit the revised drawings addressing all comments noted.	<input type="checkbox"/> D	For information only. Review/Inspection not required.		
Document Review Stamp															
<input type="checkbox"/> A	No objections subject to the comments something incorporated by the Contractor prior to the Works proceeding.														
<input checked="" type="checkbox"/> B	No objections subject to the comments being incorporated by the Contractor prior to the Works proceeding. The Contractor must re-submit the revised drawings within 14 days. Failure to re-submit within 14 days will result in a fine of 1000 AED per day.														
<input type="checkbox"/> C	Rejected as noted. The Contractor must re-submit the revised drawings addressing all comments noted.														
<input type="checkbox"/> D	For information only. Review/Inspection not required.														
Name.....  Signature.....  Date.....  SM-OME-05/10/2022		Status-B													






**OMNIYAT**

BSBG

**SHOP DRAWING**

<b>Project:</b> Plot 18 by Dorchester Collection	<b>Contractor / Package</b> Khansaheb Civil Engineering LLC	<b>Document No.</b> ELE-AX-SD-GF-09010	<b>Revision</b> 00										
<b>To:</b> Khansaheb Civil Engineering	Omniyat Middle East Real Estate Development LLC	<b>Submittal Issue Date:</b>	19.12.2022										
<b>Discipline:</b> <input type="checkbox"/> Architectural <input type="checkbox"/> Structural <input type="checkbox"/> Structural Steel <input type="checkbox"/> Electrical <input type="checkbox"/> Plumbing <input type="checkbox"/> Interior Design <input type="checkbox"/> Infrastructure <input type="checkbox"/> Landscape <input checked="" type="checkbox"/> Mechanical <input type="checkbox"/> Survey <input type="checkbox"/> Waterproofing <input type="checkbox"/> Ceiling <input checked="" type="checkbox"/> Others (.....) <i>K. Ibrahim</i>													
<b>Banquet Kitchen &amp; Support Dispense Bar Area Item No. BQ-36, 38 @ Ground Floor Level</b>		<b>Submission Type</b> <input type="checkbox"/> Material Submission <input type="checkbox"/> Manual <input type="checkbox"/> Calculation <input checked="" type="checkbox"/> Shop Drawing <input type="checkbox"/> Pre-Qualification <input type="checkbox"/> Method Statement											
<b>Location of Use:</b> Ground Floor		<b>Contract Specification Clause Ref:</b>											
<b>SPECIFIED</b>		<b>PROPOSED</b> <small>[NB: For alternative materials a Compliance Report must be provided]</small>											
MFR AGENT		MFR AGENT											
MAKE/ MODEL		MAKE/ MODEL											
<b>Contractor Review Comments:</b> <i>SN</i>			<b>Digital Stamping</b>										
Name.....	Signature.....	Date.....											
<b>Consultant Review Comments:</b>			<b>Digital Stamping</b>										
<b>Refer to drawing below for comments</b>			<b>22nd December 2022</b>										
<i>(Redacted)</i>			 <b>DORCHESTER HOTEL DUBAI</b>  <table border="1"> <tr> <td>STATUS</td> <td>DESCRIPTION</td> </tr> <tr> <td>A</td> <td>APPROVED TO PROCEED WITH NO COMMENT</td> </tr> <tr> <td>B</td> <td>APPROVED SUBJECT TO ALL COMMENTS BEING INCORPORATED</td> </tr> <tr> <td>C</td> <td>REJECTED. RESEND WITH INCORPORATING ALL COMMENTS</td> </tr> <tr> <td>D</td> <td>NO COMMENT REQUIRED FROM FONDUE TEAM</td> </tr> </table>	STATUS	DESCRIPTION	A	APPROVED TO PROCEED WITH NO COMMENT	B	APPROVED SUBJECT TO ALL COMMENTS BEING INCORPORATED	C	REJECTED. RESEND WITH INCORPORATING ALL COMMENTS	D	NO COMMENT REQUIRED FROM FONDUE TEAM
STATUS	DESCRIPTION												
A	APPROVED TO PROCEED WITH NO COMMENT												
B	APPROVED SUBJECT TO ALL COMMENTS BEING INCORPORATED												
C	REJECTED. RESEND WITH INCORPORATING ALL COMMENTS												
D	NO COMMENT REQUIRED FROM FONDUE TEAM												
<b>Lead Consultant Review Comments:</b> <b>Refer Fondue comments &amp; incorporate</b>			<b>Digital Stamping</b>										
<i>(Redacted)</i>													
Name.....	Signature..... <b>GD</b>	Date..... <b>22.12.2022</b>											
<b>Employer's Representative (Omniyat) Review Comments:</b>  <i>Refer to Fondue comments and ensure proper coordination with ID where required.</i>			<b>Digital Stamping</b>										
			<b>Code - B</b>										
Name..... <b>Ahmed Ibrahim</b> Signature..... <b>AI</b> Date..... <b>27 Dec 2022</b>													

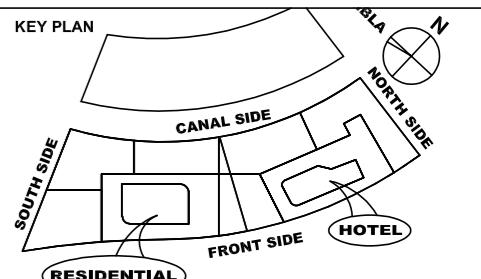


NOTES:  
1. ALL DIMENSION ARE IN MILLIMETERS.

LEGENDS:

GROUND FLOOR		
AREA: BANQUET KITCHEN AND SUPPORT / DISPENSE BAR		
ITEM No.	DESCRIPTION	QTY.
BQ.36	REAR BEVERAGE COUNTER	1
BQ.38	WINE RACKS	3

Wall and bottom mounting details to be indicated

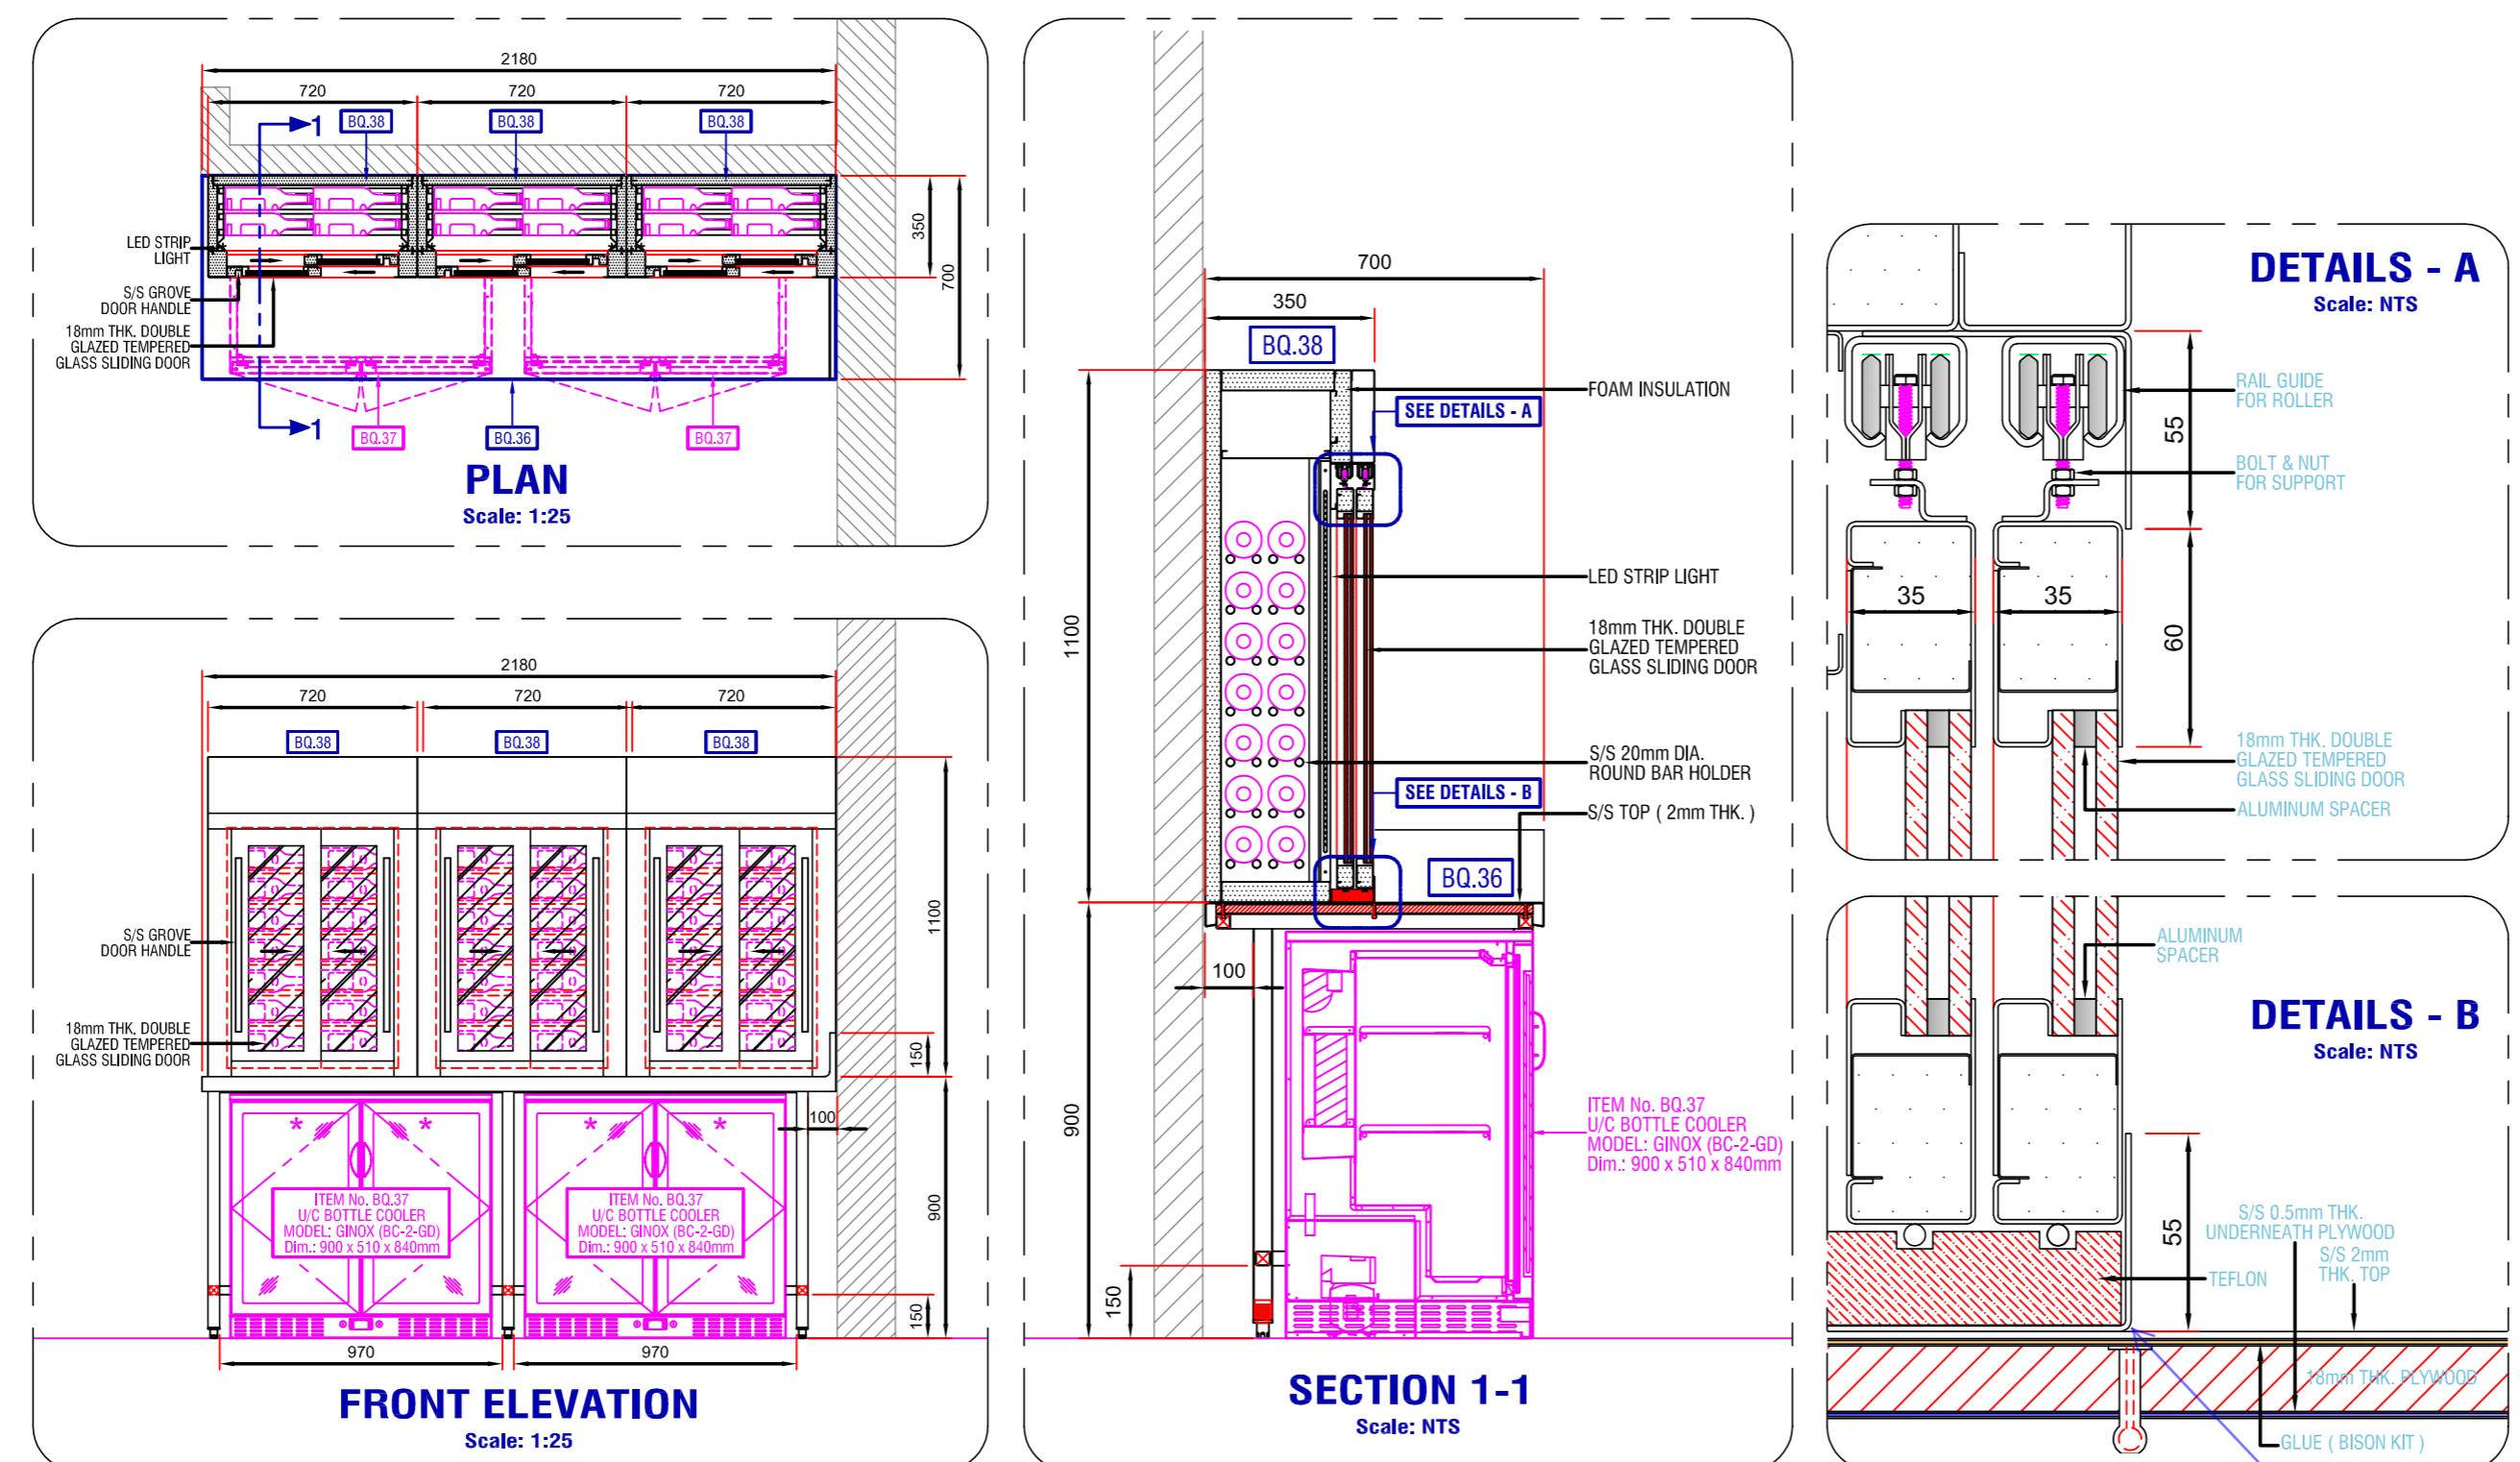

KEY PLAN			
<b>NOTES:</b> 1. ALL DIMENSION ARE IN MILLIMETERS.			
<b>LEGENDS:</b>			
<b>DRAWING NO., REV., DRAWING TITLE</b>			
<b>REFERENCES</b>			
S.NO. DRAWING NO./REV. DRAWING TITLE 00 GENERAL ARRANGEMENT OF EQUIPMENT LAYOUT			
<b>ISSUED FOR APPROVAL</b> 09-12-2022 BY Rev. Description Date BY			
Certified for Coordination and Compliance with the Contract documents			
Date.	Subcontractor	Stg.	
MEP - ELECTRICAL MEP - PLUMBING MEP - HVAC ALUMINUM OTHERS			
<b>KHANSAHEB REVIEW</b>			
Date	Signature		
<b>CLIENT:</b> OMNIYAT PROPERTIES FIFTEEN LTD LEVEL 26, ONE BUSINESS BAY TOWER BUSINESS BAY, DUBAI U.A.E. T +971 4 5115000 F +971 4 5115005			
<b>DESIGN CONSULTANT:</b> BREWER SMITH BREWER GULF P.O.BOX:50087 DUBAI U.A.E. T +971 4 2942042 F +971 4 2942101 EMAIL:INFO@BSBEGULF.COM			
<b>STRUCTURE ENGINEER:</b> BG&E 1001-1008 PUSSELDORF BUSINESS POINT, INTERCHANGE 4, AL BARSHA 1, DUBAI U.A.E T +971 4 4475224 EMAIL:BG&E@GMAIL.COM WWW.BGEENG.COM			
<b>MEP ENGINEER:</b> Offices 4-6 Ground Floor, Block A EXCELSIOR Premium Building Sheikh Zayed Road, Dubai, U.A.E Post Box: 50080, P.O.Box: 103 Tel: +971 4 3881616 Mail: info@wmeglobal.com			
<b>MEP CONSULTANTS:</b> Consistent Engineering Consultants Post Box No:125786, Bank Street, Bur Dubai - U.A.E Tel: +971 4 3860604 Fax: +971 4 3860602 Email: info@consistentconsultants.com Website: consistentconsultants.com			
<b>MAIN CONTRACTOR:</b> KHANSAHEB KHANSAHEB CIVIL ENGINEERING L.L.C. Tel: 04 605 7200, Fax: 04 285 7539, www.khansahab.ae			
<b>SUB CONTRACTOR:</b> elenco Post Box 1400, Al Maryah Islands - Abu Dhabi - U.A.E Tel: 02 2137 103 Fax: 02 2137 103 Email: info@elencogroup.com			
<b>PROJECT:</b> <b>PROPOSED DEVELOPMENT ON PLOT 3466829</b> <b>PLOT 18 DUBAI, UAE</b>			
<b>DRAWING TITLE:</b> BANQUET KITCHEN AND SUPPORT DISPENSE BAR AREA ITEM No. BQ.36, 38 @ GROUND FLOOR LEVEL			
Drawn:-	TAJ	Checked:-	RA
Authorised:-	RA		
SCALE	1:25 @ A2	DATE	09-12-2022
DRAWING NO.	ELE-AZ-SD-GF-09010	REV.	00